


WGS 84 POSITIONS can be plotted directly on this chart

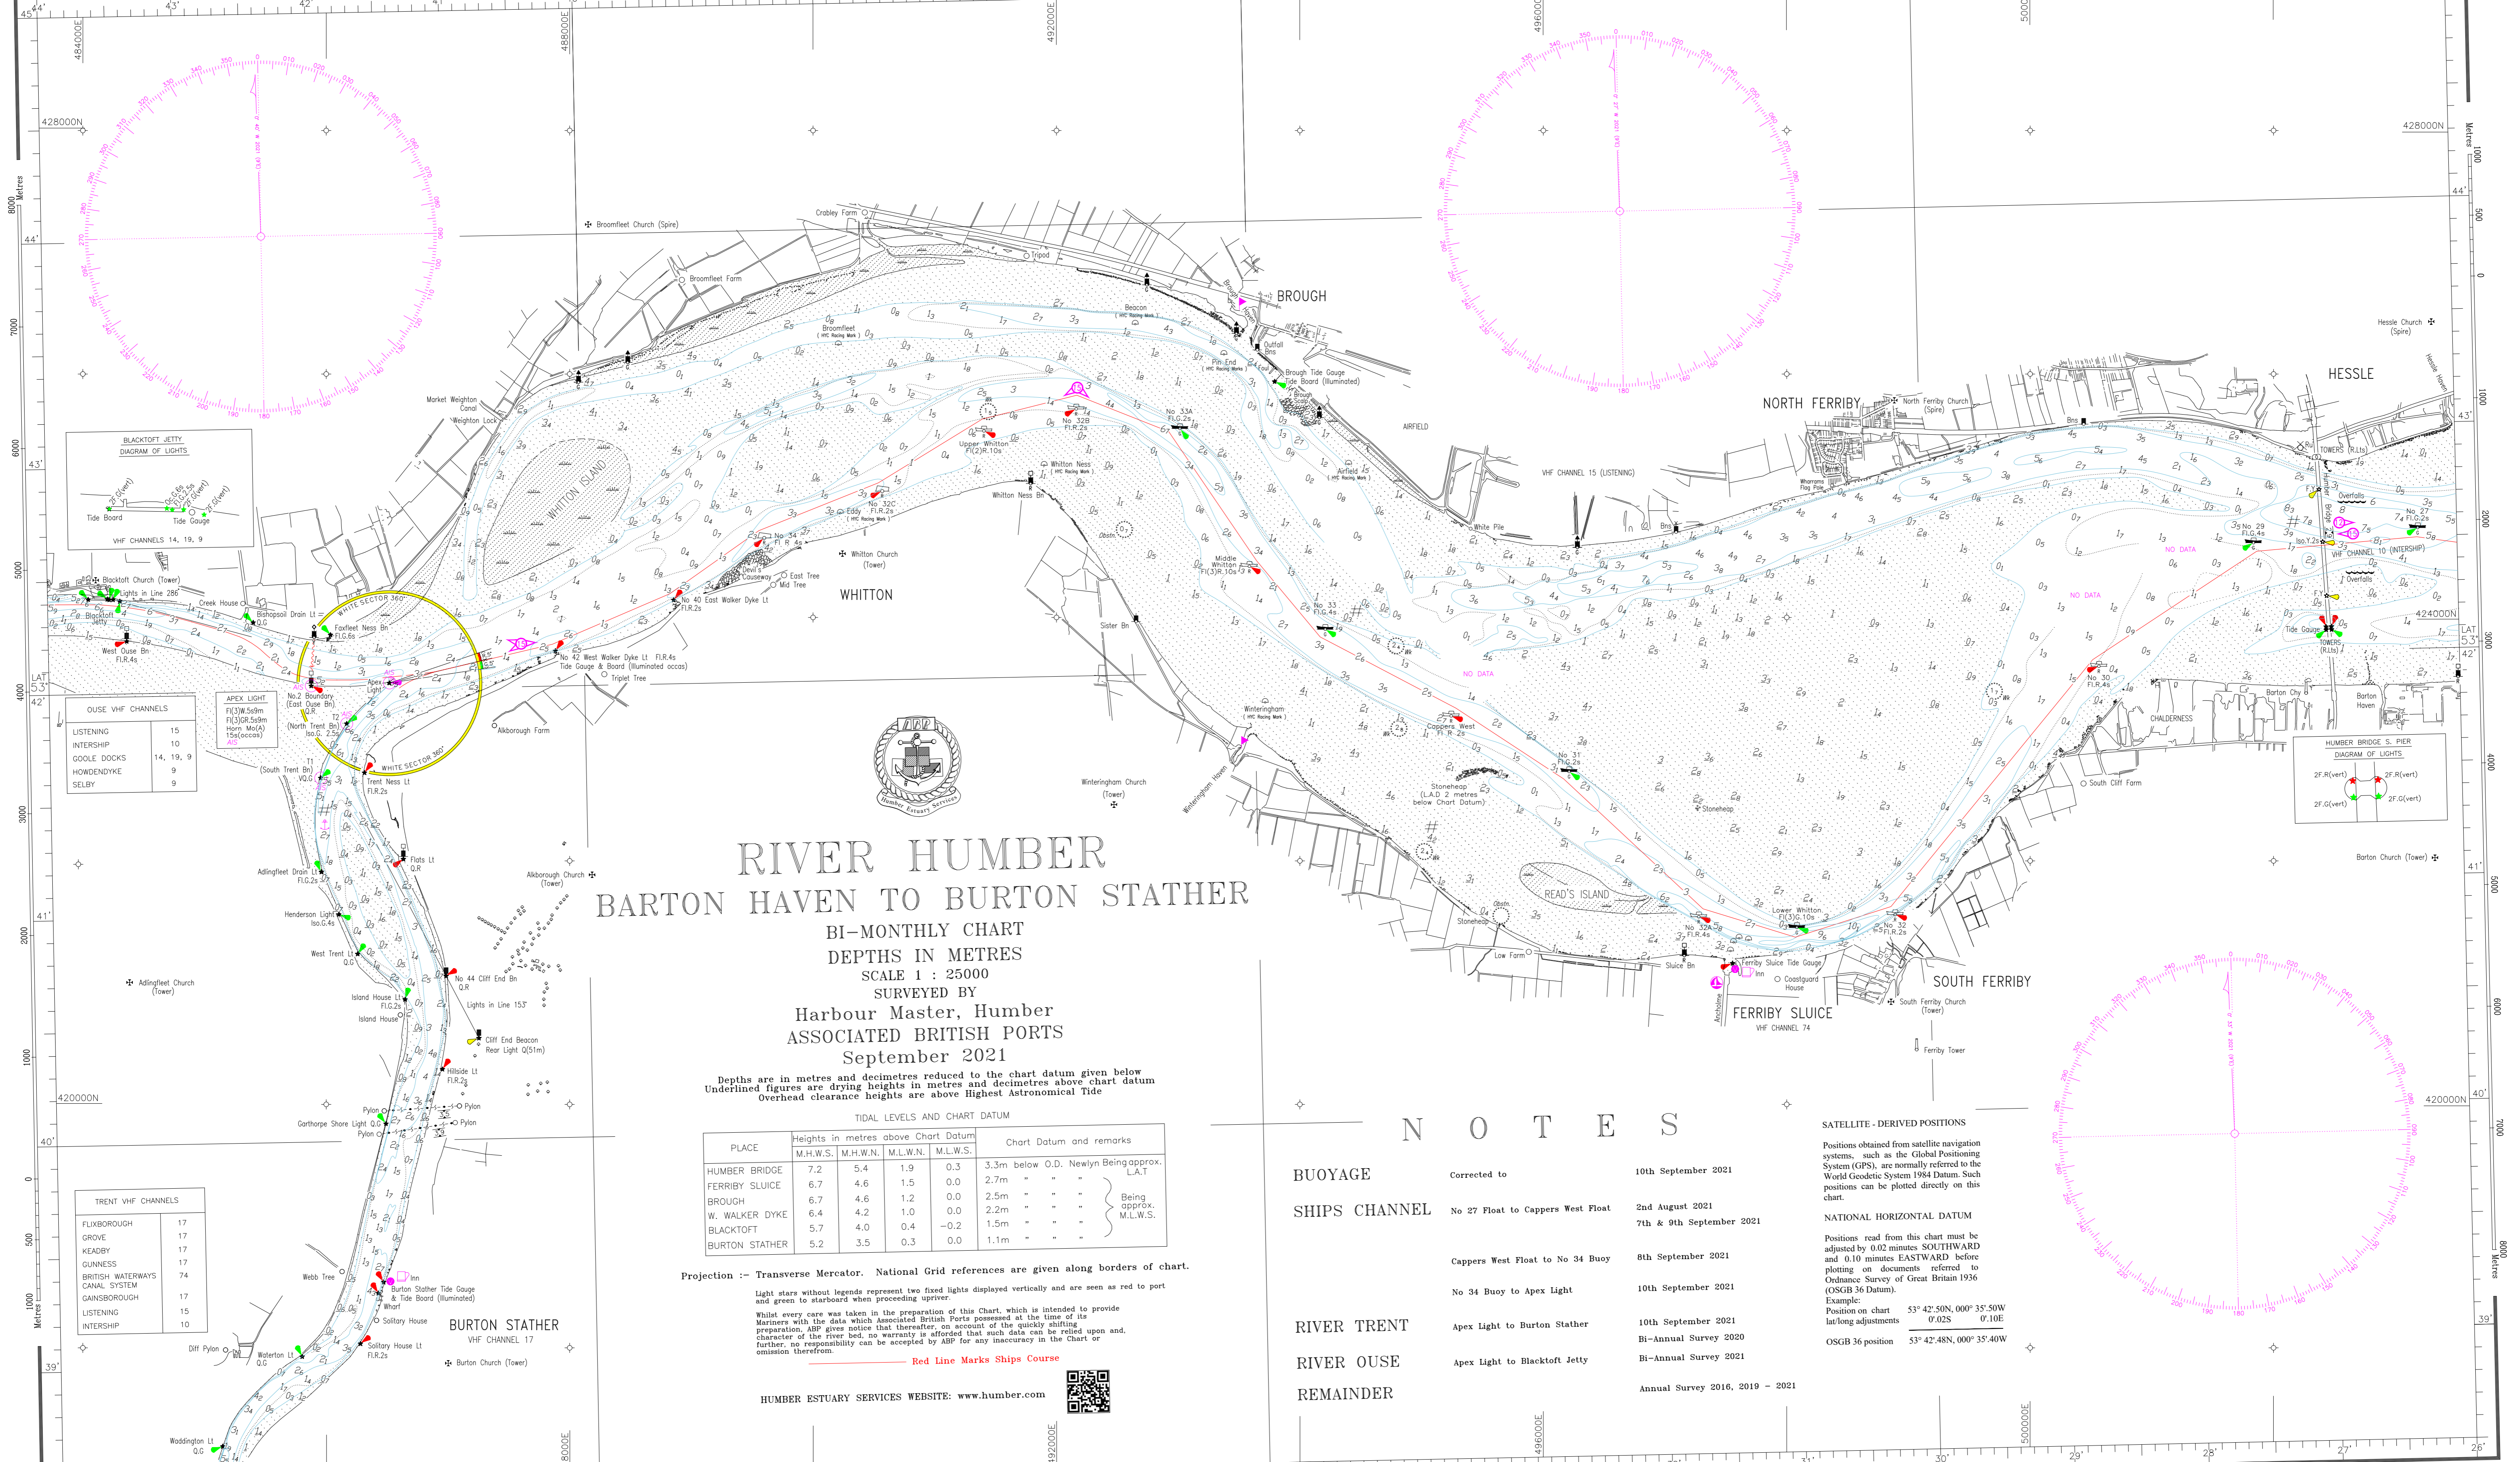

# RIVER HUMBER BARTON HAVEN TO BURTON STATHER

BI-MONTHLY CHART  
DEPTHS IN METRES  
SCALE 1 : 25000  
SURVEYED BY  
Harbour Master, Humber  
ASSOCIATED BRITISH PORTS  
September 2021

Depths are in metres and decimetres reduced to the chart datum given below  
Underlined figures are drying heights in metres and decimetres above chart datum  
Overhead clearance heights are above Highest Astronomical Tide

TIDAL LEVELS AND CHART DATUM

PLACE	Heights in metres above Chart Datum				Chart Datum and remarks
	M.H.W.S.	M.H.W.N.	M.L.W.N.	M.L.W.S.	
HUMBER BRIDGE	7.2	5.4	1.9	0.3	3.3m below O.D. Newly Being approx. L.A.T
FERRIBY SLUICE	6.7	4.6	1.5	0.0	2.7m " " " " " "
BROUGH	6.7	4.6	1.2	0.0	2.5m " " " " " "
W. WALKER DYKE	6.4	4.2	1.0	0.0	2.2m " " " " " "
BLACKTOFT	5.7	4.0	0.4	-0.2	1.5m " " " " " "
BURTON STATHER	5.2	3.5	0.3	0.0	1.1m " " " " " "

Projection :- Transverse Mercator. National Grid references are given along borders of chart.

Light stars without legends represent two fixed lights displayed vertically and are seen as red to port and green to starboard when proceeding upriver.  
Whilst every care was taken in the preparation of this Chart, which is intended to provide mariners with the data which associated British Ports possessed at the time of its preparation, ABP gives notice that thereafter, on account of the quickly shifting character of the river bed, no warranty is afforded that such data can be relied upon and further, no responsibility can be accepted by ABP for any inaccuracy in the Chart or omission therefrom.

Red Line Marks Ships Course

HUMBER ESTUARY SERVICES WEBSITE: [www.humber.com](http://www.humber.com)



## N O T E S

BUOYAGE	Corrected to	10th September 2021
SHIPS CHANNEL	No 27 Float to Cappers West Float	2nd August 2021 7th & 9th September 2021
	Cappers West Float to No 34 Buoy	8th September 2021
	No 34 Buoy to Apex Light	10th September 2021
RIVER TRENT	Apex Light to Burton Stather	10th September 2021
RIVER OUSE	Apex Light to Blacktoft Jetty	Bi-Annual Survey 2020
REMAINDER		Bi-Annual Survey 2021 Annual Survey 2016, 2019 - 2021

SATELLITE - DERIVED POSITIONS

Positions obtained from satellite navigation systems, such as the Global Positioning System (GPS), are normally referred to the World Geodetic System 1984 Datum. Such positions can be plotted directly on this chart.

NATIONAL HORIZONTAL DATUM

Positions read from this chart must be adjusted by 0.02 minutes SOUTHWARD and 0.10 minutes EASTWARD before plotting on documents referred to the Ordnance Survey of Great Britain 1936 (OSGB 36 Datum).  
Example:  
Position on chart 53° 42.50N, 000° 35.50W  
lat/long adjustments 0.02S 0.10E  
OSGB 36 position 53° 42.48N, 000° 35.40W

WGS 84 POSITIONS can be plotted directly on this chart