


WGS 84 POSITIONS can be plotted directly on this chart

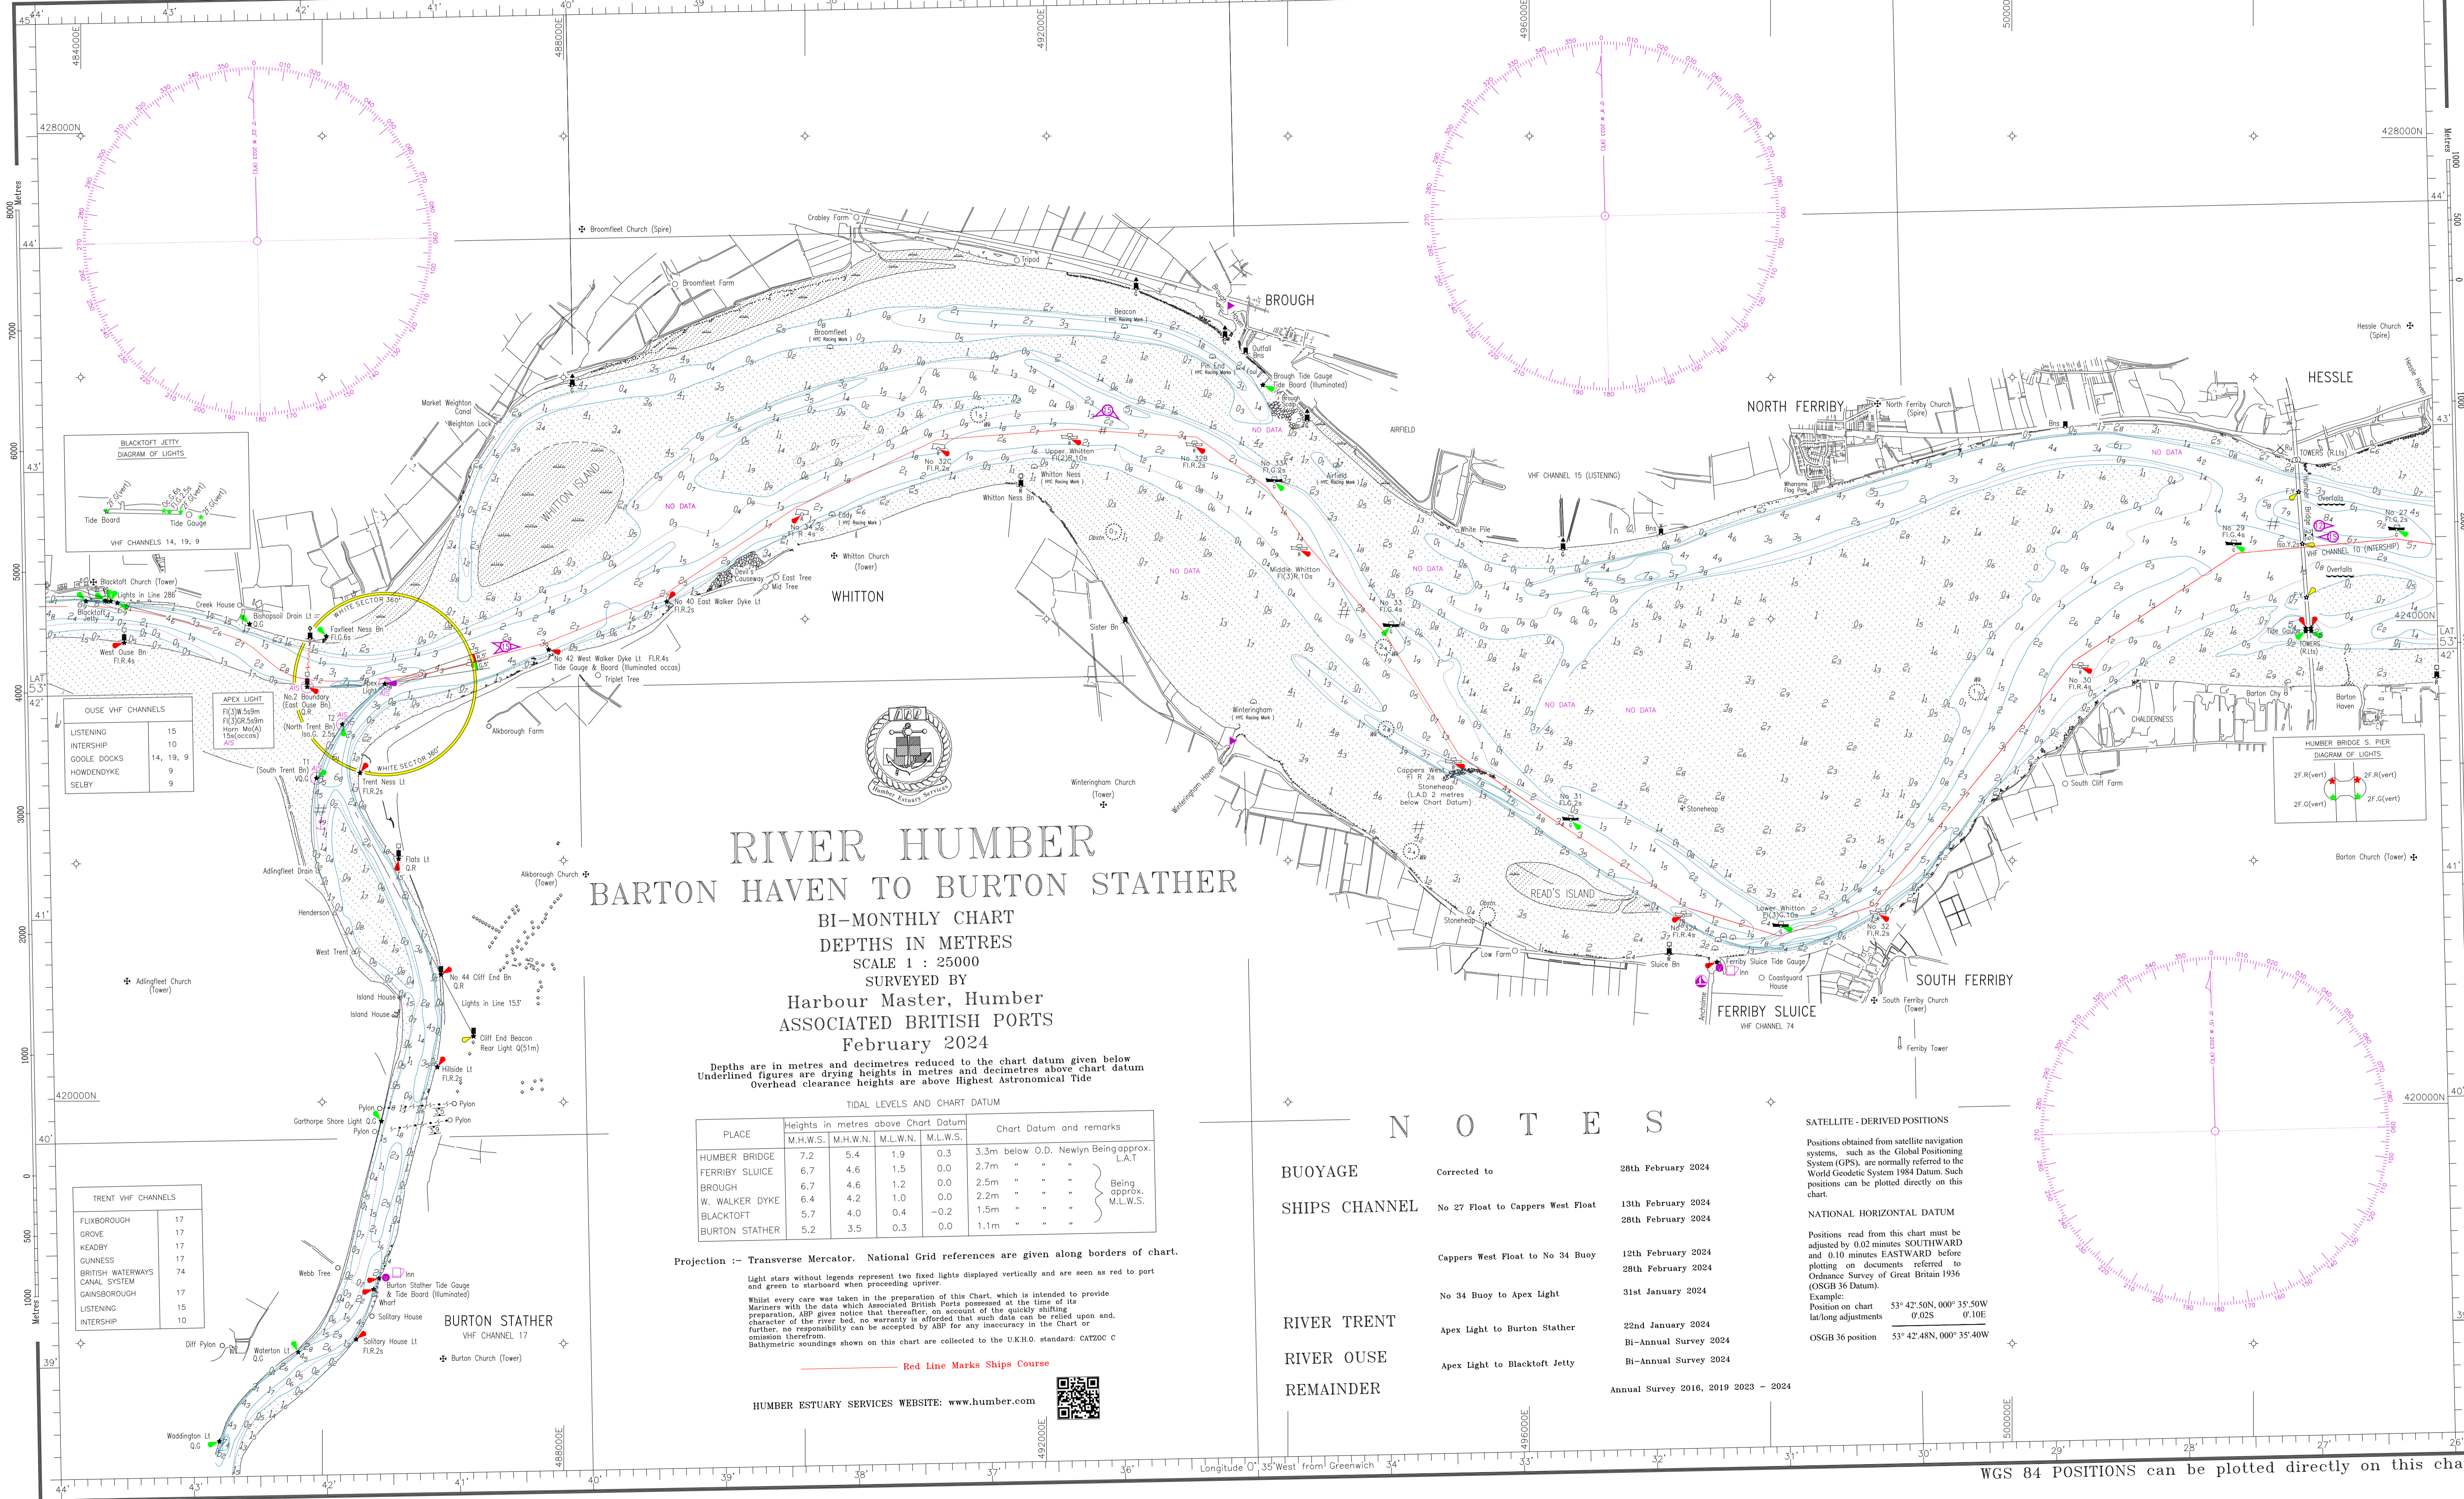

RIVER HUMBER BARTON HAVEN TO BURTON STATHER

BI-MONTHLY CHART
DEPTHS IN METRES
SCALE 1 : 25000

SURVEYED BY
**Harbour Master, Humber
ASSOCIATED BRITISH PORTS**
February 2024

Depths are in metres and decimetres reduced to the chart datum given below
Underlined figures are drying heights in metres and decimetres above chart datum
Overhead clearance heights are above Highest Astronomical Tide

TIDAL LEVELS AND CHART DATUM

PLACE	Heights in metres above Chart Datum				Chart Datum and remarks
	M.H.W.S.	M.H.W.N.	M.L.W.N.	M.L.W.S.	
HUMBER BRIDGE	7.2	5.4	1.9	0.3	3.3m below O.D. Newlyn Being approx. L.A.T
FERRY SLUICE	6.7	4.6	1.5	0.0	2.7m " " " " " " " " " " " "
BROUGH	6.7	4.6	1.2	0.0	2.5m " " " " " " " " " " " "
W. WALKER DYKE	6.4	4.2	1.0	0.0	2.2m " " " " " " " " " " " "
BLACKTOFT	5.7	4.0	0.4	-0.2	1.5m " " " " " " " " " " " "
BURTON STATHER	5.2	3.5	0.3	0.0	1.1m " " " " " " " " " " " "

Projection :- Transverse Mercator. National Grid references are given along bottom of chart.

Light stars without legends represent two fixed lights displayed vertically and are seen as red to port and green to starboard when proceeding upriver.
Whilst every care was taken in the preparation of this Chart, which is intended to provide Mariners with the data which Associated British Ports possessed at the time of its preparation, ABP gives notice that therefore, on account of the quickly shifting character of the river bed, no warranty is afforded that such data can be relied upon and, further, no responsibility can be accepted by ABP for any inaccuracy in the Chart or omission therefrom.
Bathymetric soundings shown on this chart are collected to the U.K.H.O. standard: CATZOC C

Red Line Marks Ships Course

HUMBER ESTUARY SERVICES WEBSITE: www.humber.com



N O T E S

- BUOYAGE** Corrected to 28th February 2024
- SHIPS CHANNEL** No 27 Float to Cappers West Float 13th February 2024
28th February 2024
- Cappers West Float to No 34 Buoy 12th February 2024
28th February 2024
- No 34 Buoy to Apex Light 31st January 2024
- RIVER TRENT** Apex Light to Burton Stather 22nd January 2024
Bi-Annual Survey 2024
- RIVER OUSE** Apex Light to Blacktoft Jetty Bi-Annual Survey 2024
- REMAINDER** Annual Survey 2016, 2019 2023 - 2024

SATELLITE - DERIVED POSITIONS

Positions obtained from satellite navigation systems, such as the Global Positioning System (GPS), are normally referred to the World Geodetic System 1984 Datum. Such positions can be plotted directly on this chart.

NATIONAL HORIZONTAL DATUM

Positions read from this chart must be adjusted by 0.02 minutes SOUTHWARD and 0.10 minutes EASTWARD before plotting on documents referred to Ordnance Survey of Great Britain 1936 (OSGB 36 Datum).
Example:
Position on chart 53° 42' 50N, 000° 35' 50W
lat/long adjustments 0.02S 0.10E
OSGB 36 position 53° 42' 48N, 000° 35' 40W

WGS 84 POSITIONS can be plotted directly on this chart