

WGS 84 POSITIONS can be plotted directly on this chart



# RIVER HUMBER HESSLE SAND

## DEPTHS IN METRES

SURVEYED BY  
Harbour Master, Humber  
ASSOCIATED BRITISH PORTS



Depths are in metres and decimals reduced to the chart datum given below  
TIDAL LEVELS AND CHART DATUM

PLACE	M.H.W.S.	M.L.W.N.	M.L.W.N.	M.L.W.S.	Chart Datum and remarks
KING GEORGE DOCK	7.6	6.0	2.5	0.7	3.9m below O.D. Newlyn
ALBERT DOCK	7.6	5.9	2.5	0.7	3.9m below O.D. Newlyn
HUMBER BRIDGE	7.2	5.4	1.9	0.3	3.3m below O.D. Newlyn

Projection: Transverse Mercator. National Grid references are given along borders of chart  
Bathymetric soundings shown on this chart are corrected to the datum shown above.

Red Line Marks Ships Course  
Red Hatched Line Marks Proposed Ships Course

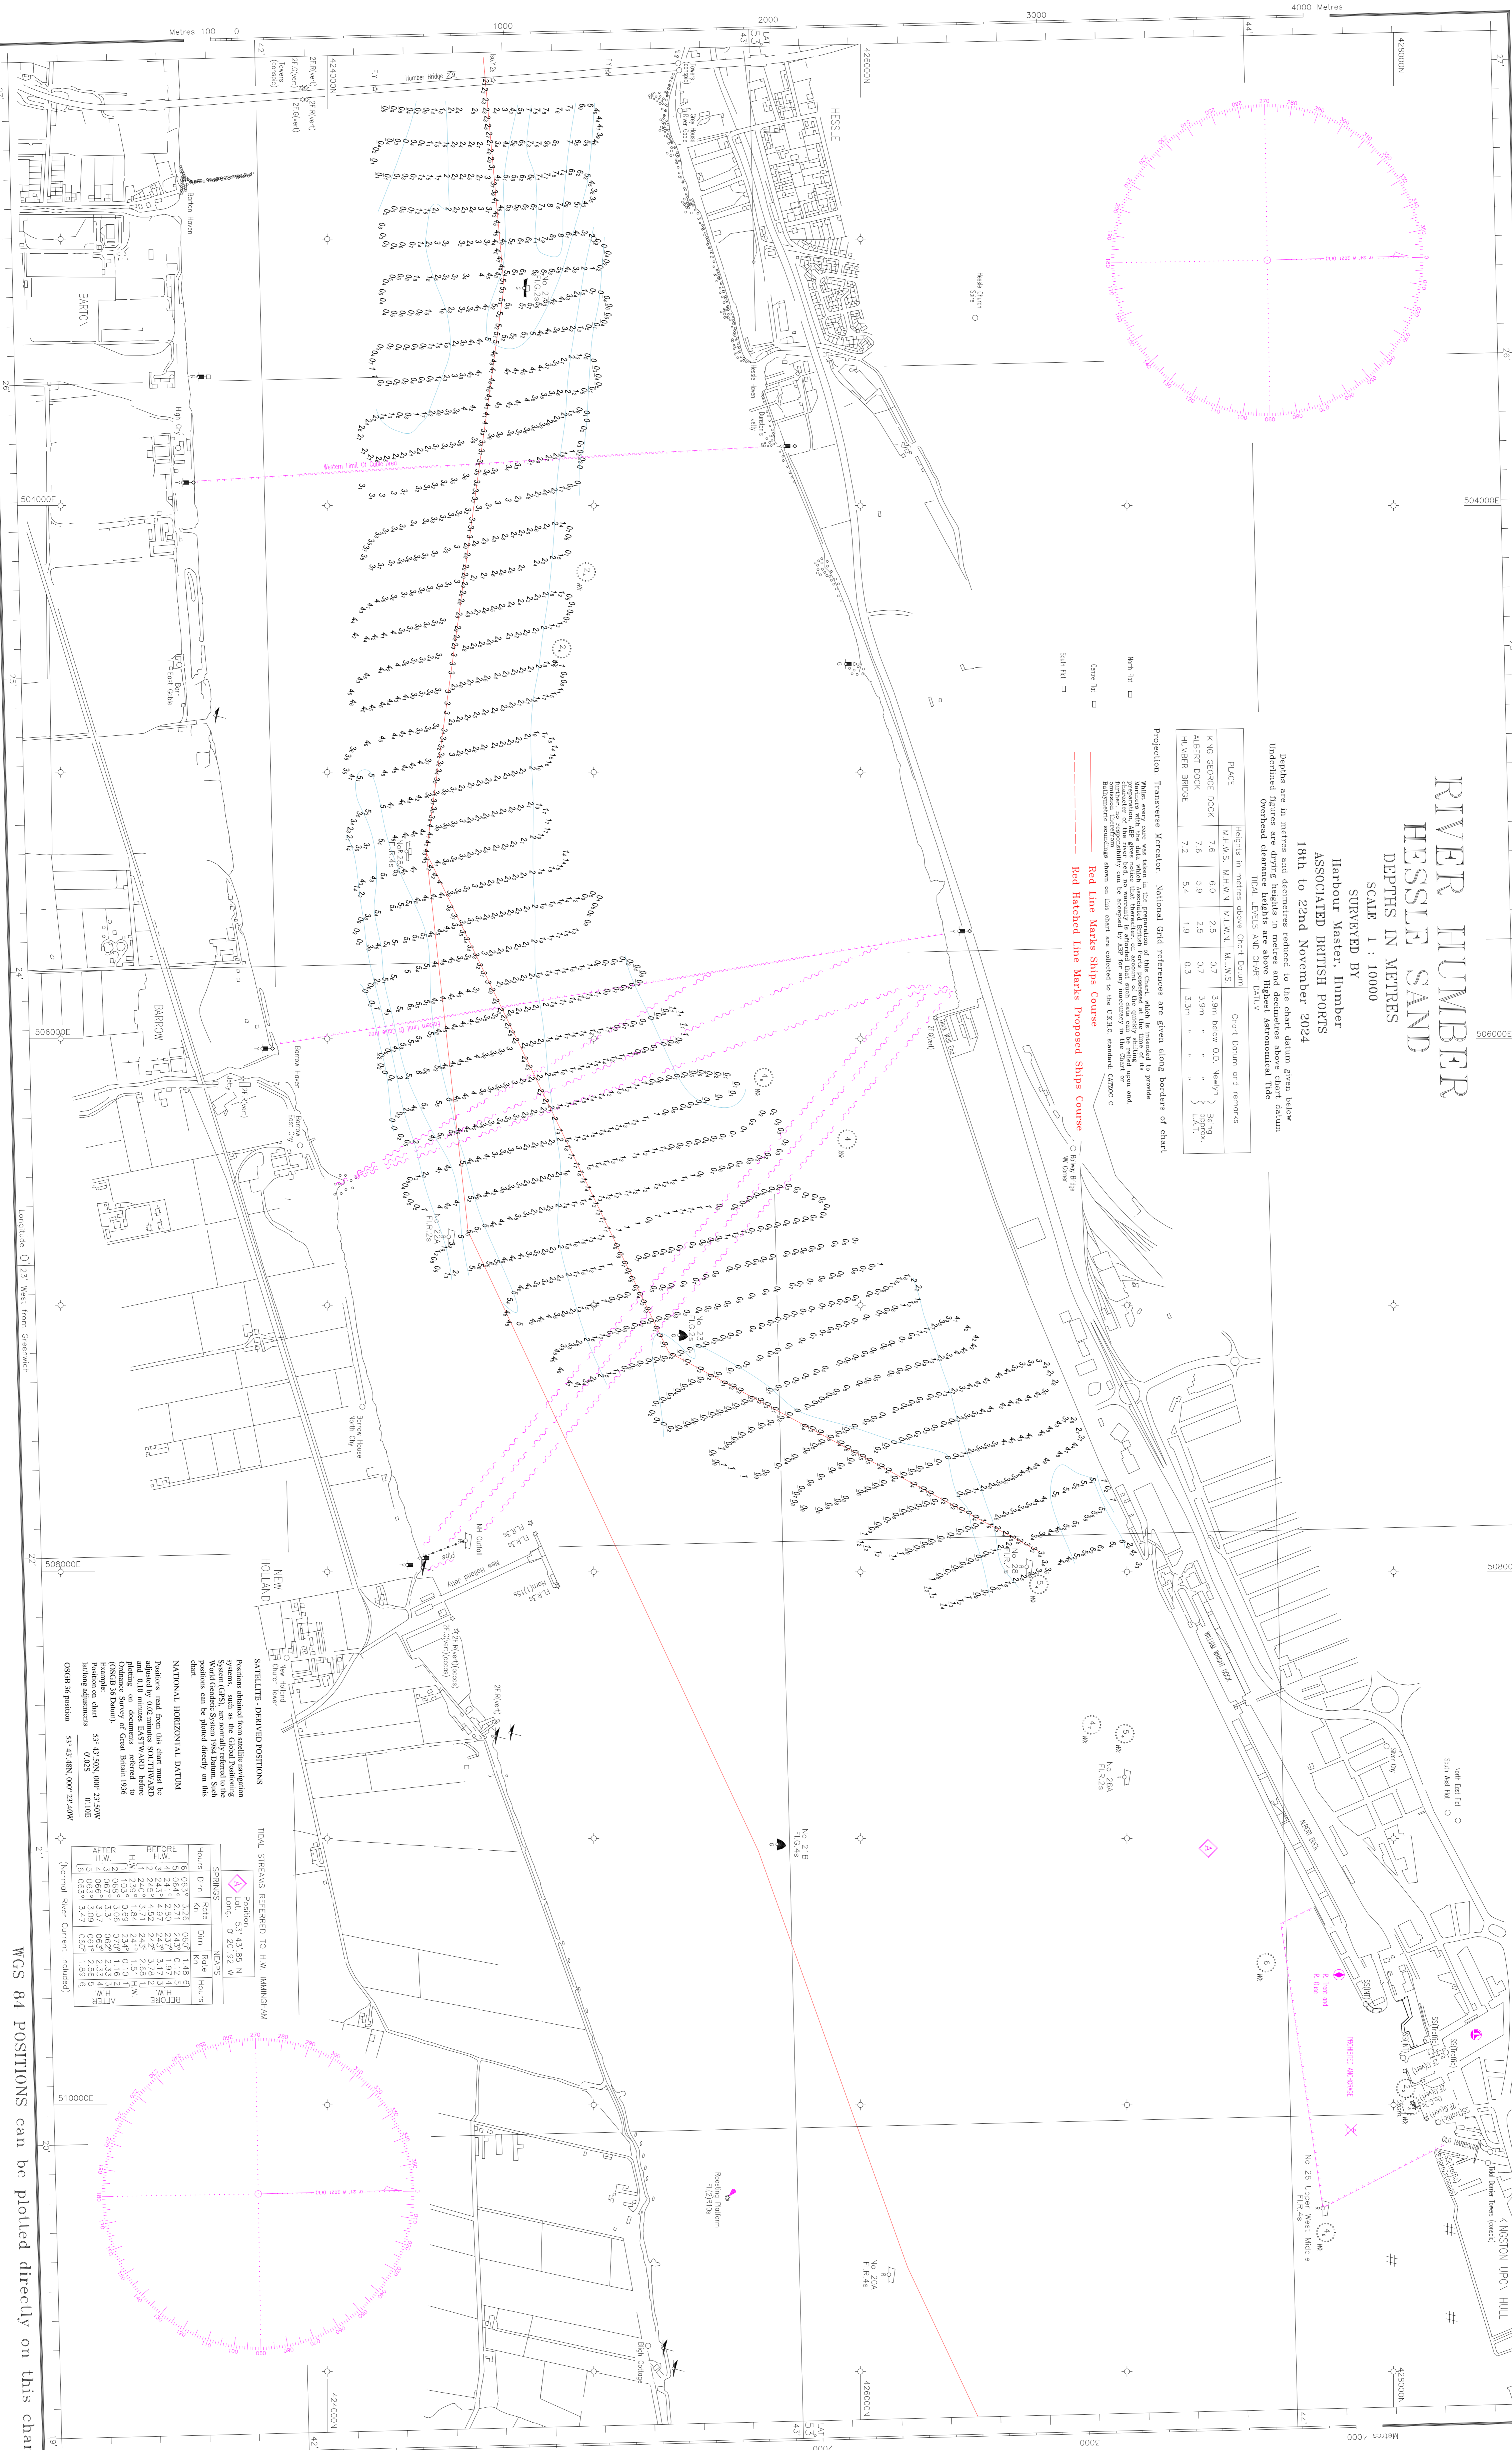

**SATELLITE-DERIVED POSITIONS**  



WGS 84 POSITIONS can be plotted directly on this chart

© Copyright 2024. All rights reserved. No part of this product may be reproduced in any form (including photocopying or by electronic means) without prior permission.