

WGS 84 POSITIONS can be plotted directly on this chart

© Copyright 2026. All rights reserved. No part of this product may be reproduced in any form (including photocopying or by electronic means) without prior permission.


RIVER HUMBER HESSLE SAND

DEPTHS IN METRES
SCALE 1 : 10000
SURVEYED BY
Harbour Master, Humber
ASSOCIATED BRITISH PORTS

Depths are in metres and decreasers reduced to the chart datum given below

PLACE	M.H.W.S	M.L.W.N.	M.L.W.S.	Chart Datum and remarks
KING GEORGE DOCK	7.6	6.0	2.5	0.7 3.9m below O.D. Newlyn
ALBERT DOCK	7.6	5.9	2.5	0.7 3.9m - - - - -
HUMBER BRIDGE	7.2	5.4	1.9	0.3 3.5m - - - - -

Projection: Transverse Mercator. National Grid references are given along borders of chart
Red Line Marks Ships Course
Red Hatched Line Marks Proposed Ships Course

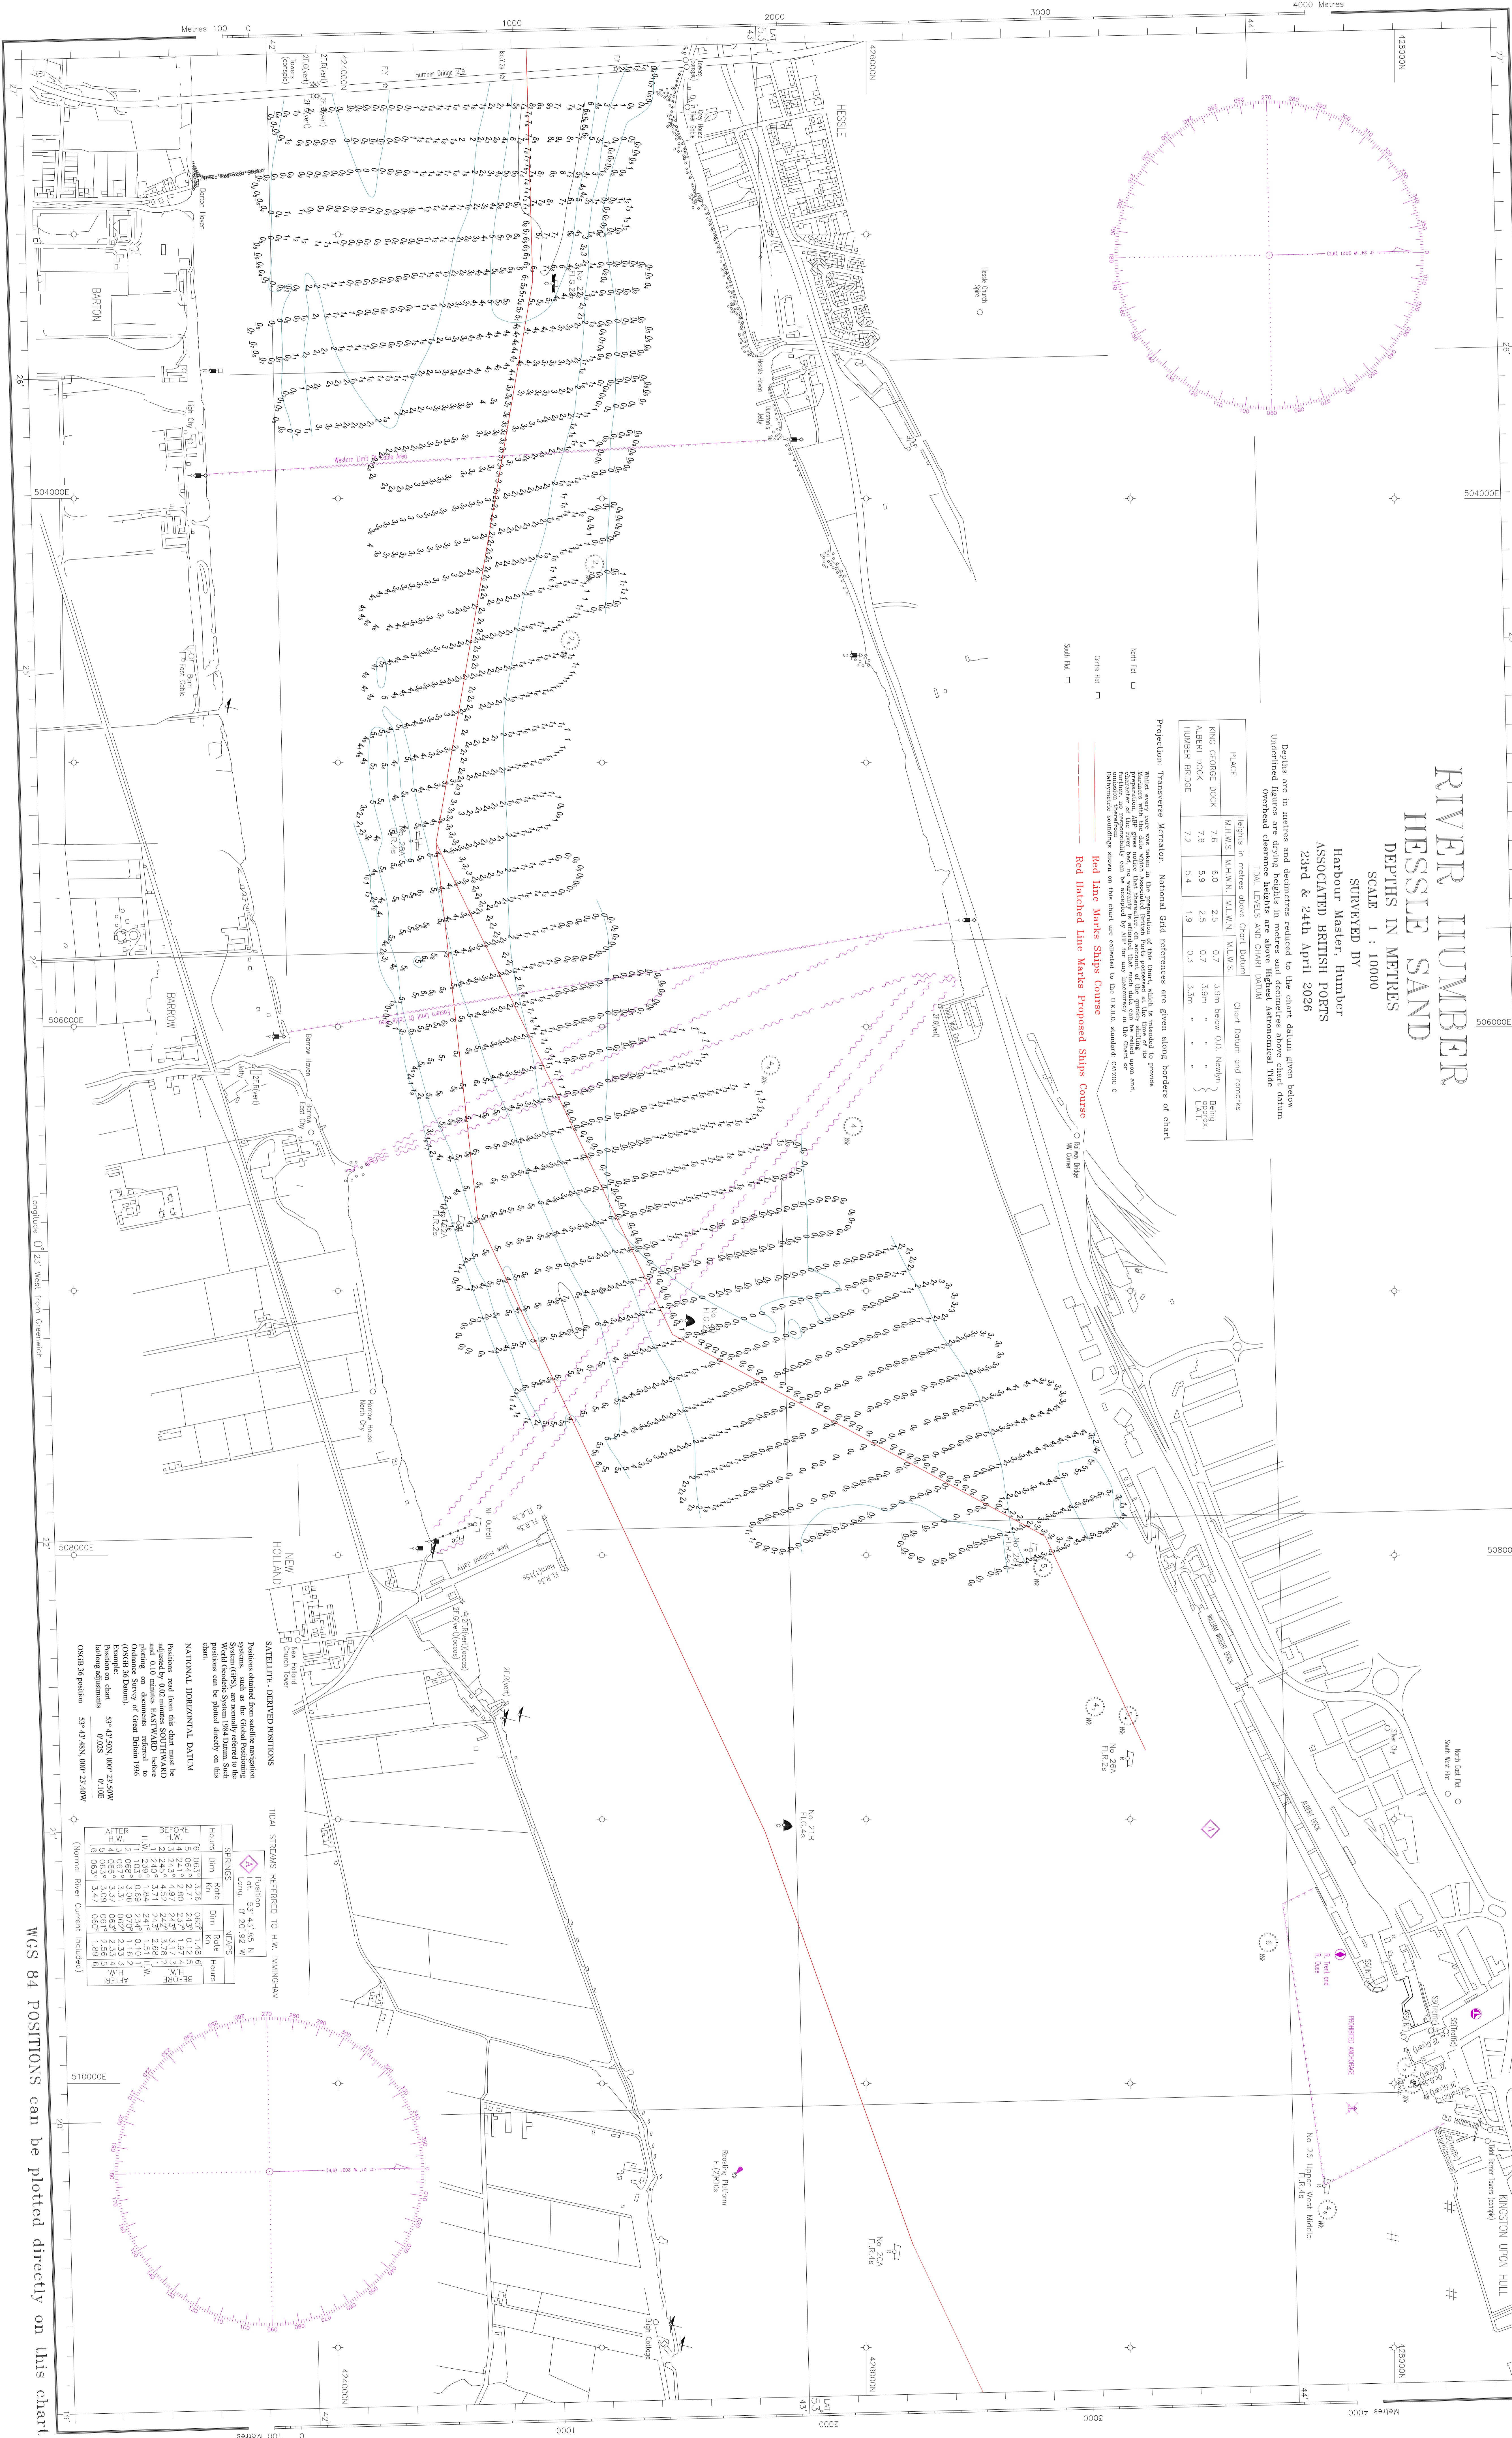

SATELLITE-DERIVED POSITIONS
Positions obtained from satellite navigation systems (GPS) are normally referred to the World Geodetic System 1984 Datum. Such positions can be plotted directly on this chart.

NATIONAL HORIZONTAL DATUM
(Normal River Current included)



WGS 84 POSITIONS can be plotted directly on this chart